


SURVEY CONTROL POINTS				
POINT NO.	NORTHING	EASTING	ELEVATION	DESCRIPTION
100	4228	8370	81.62	FD BM T-435
101	4285	8285	76.15	FD BRASS DISC
102	3944	8714		

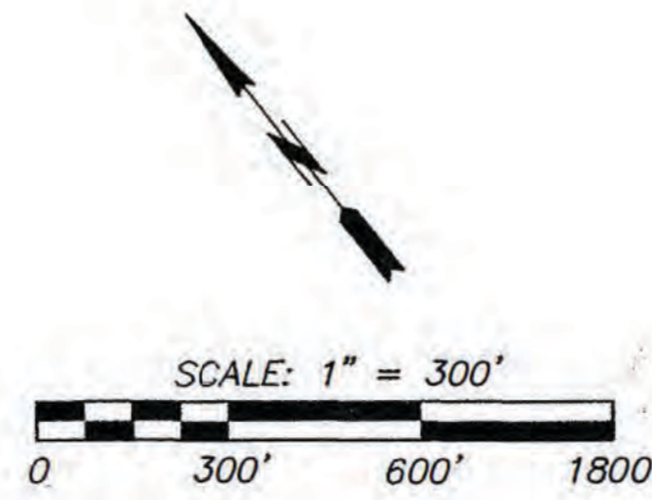

RECORD DRAWING				
REV	DATE	DESCRIPTION	BY	CHECKED
	1/5/07	Trenching 24" deep/ Native backfill		
	1/7/07	3" schedule 40 PVC conduit		
	1/8/07	3" schedule 80 PVC conduit (underneath taxiways)		
	3/4/07	#8 AWG 5 KV (Draka Cabletag USA FAA-L-824)		
10		Complete light fixtures assemblies, Incl. Transformers		
7		Waterproof Vaults 36"W x 48" L x 36" d		
3		Approx 50'-60' Bores (for 3" sch. 80 PVC conduits)		

**CITY OF TORRANCE**

**ZAMPERINI FIELD Taxiway Lighting**

---

SCALE: 1"=300'      SHEET 4 OF 23      GN-4

PLAN NO.      **AP-177A**

08/25/07 09:36 P:\PROJECTS\Torrance Municipal Airport\LD Design\4.1 Drawings\Sheet\04-04.dwg