

**ADDENDUM # 1**

**CITY OF TORRANCE  
3031 Torrance Blvd.  
Torrance, CA 90503**

**BID NO. B2022-41**

---

**BID for Taxiway Lights and Wire Replacement at Torrance Municipal Airport (Re-Bid)**

---

ADDENDUM # 1 - Issued 11/15/22

THE FOLLOWING CHANGES ARE HEREBY INCORPORATED INTO AND MADE A MANDATORY PART OF SUBJECT BID:

CLARIFY: The Bid Due Date remains on **Wednesday, November 23, 2022 by 3:00 PM** in the Office of the City Clerk, 3031 Torrance Blvd., Torrance, CA 90503. **NO FAXED PROPOSALS ACCEPTED.**


CLARIFY: Airport Taxiway Light Plan attached for your reference, also available online at: <https://www.torranceca.gov/government/general-services/completed-projects>

Please return this addendum with your bid proposal. Failure to acknowledge addenda and submit it with your proposal may render the proposal non-responsive and cause it to be rejected. I hereby acknowledge receipt of this addendum.

\_\_\_\_\_  
Name of Company


\_\_\_\_\_  
Address

\_\_\_\_\_  
City      State      Zip Code

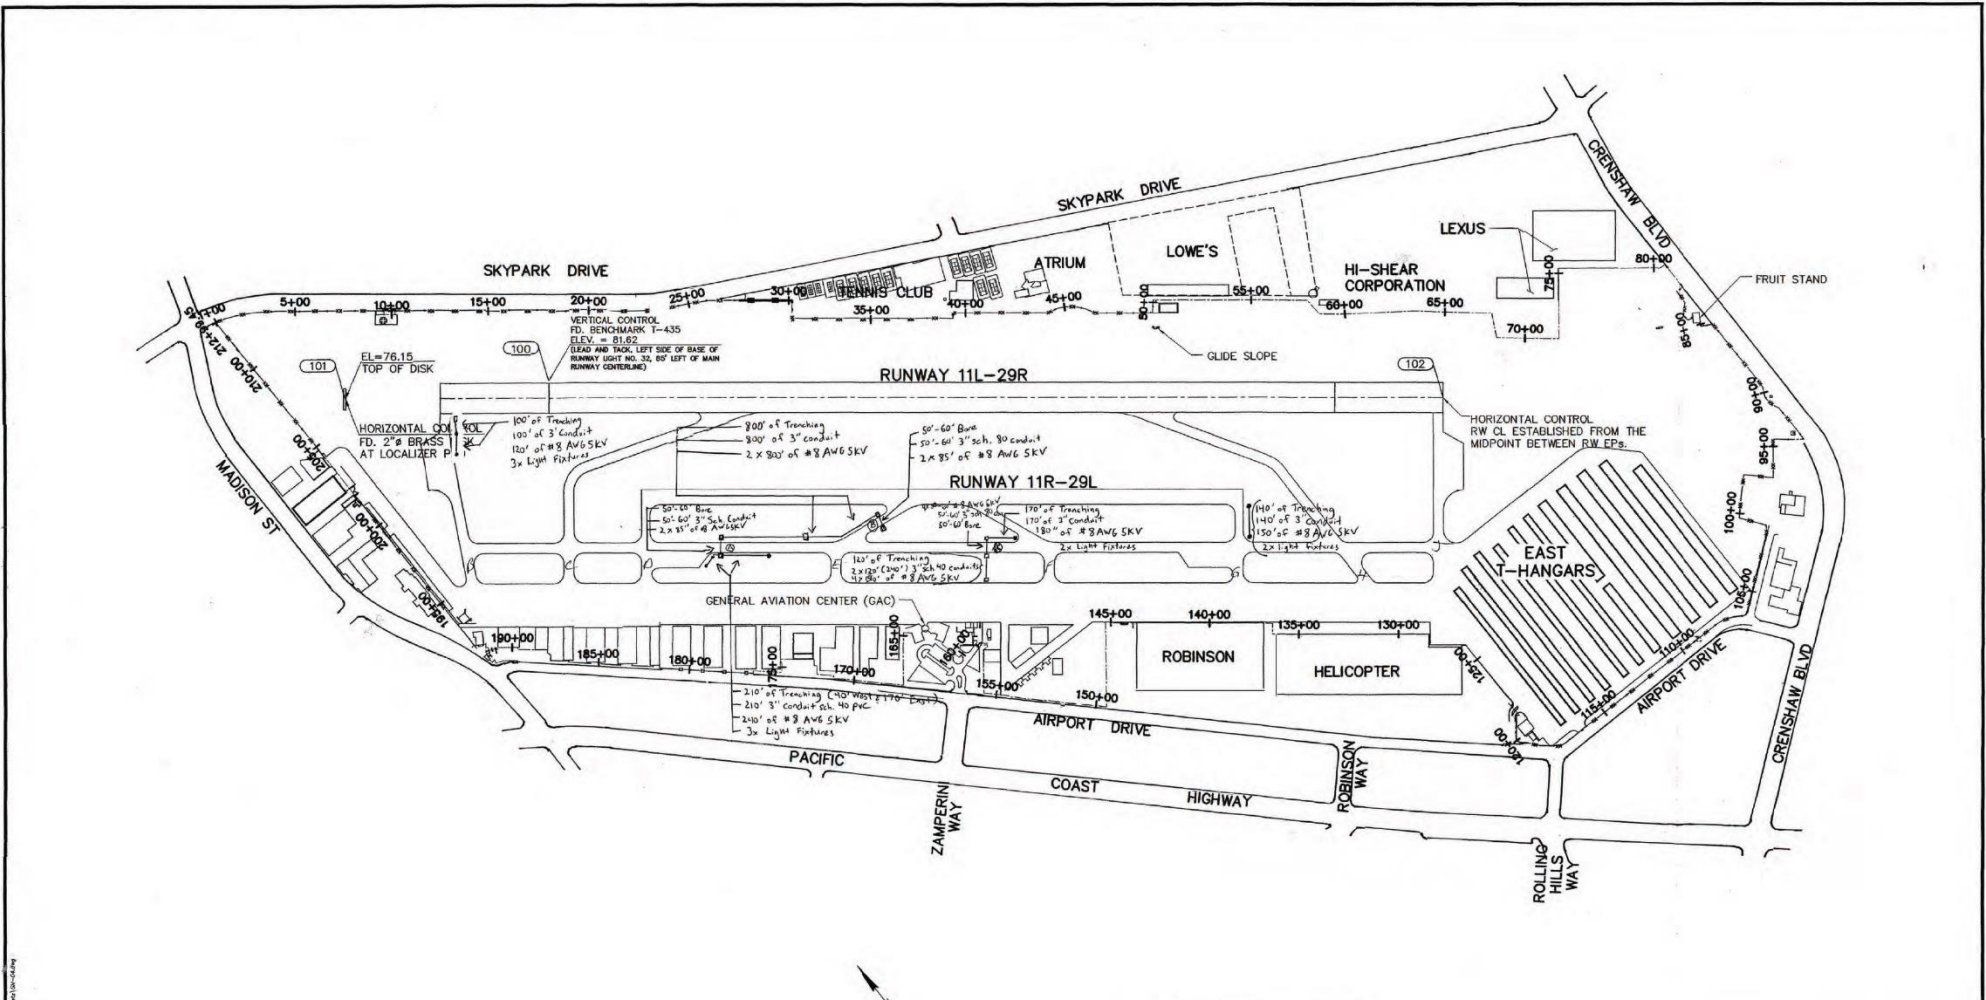

(100) SURVEY CONTROL POINTS

POINT NO.	NORTHING	EASTING	ELEVATION	DESCRIPTION
100	4228	8370	81.82	FD BM T-435
101	4285	8285	76.15	FD BRASS DISC
102	3944	8714		

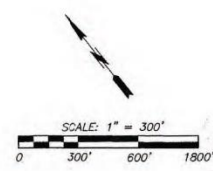

**RECORD DRAWING**

REV	DATE	DESCRIPTION	BY	CHECKED
1	1/4/00	Trenching 24" deep/native backfill		
2	1/7/00	3" schedule 40 PVC conduit		
3	1/8/00	3" schedule 80 PVC conduit (underneath existing) <i>changes</i>		
4	2/4/00	#8 AWG 5 KV (Draka Cabling USA FAA-L-924 - Type E cable)		
5	10	Complete light fixtures assemblies, Incl. Transformers		
6	7	Waterproof Vaults 36" W x 48" L x 36" D		
7	3	Approx 50'-60' Bores (for 3" sch. 80 PVC conduits)		

**CITY OF TORRANCE**

**ZAMPERINI FIELD Taxiway Lighting**

SCALE: 1"=300' SHEET 4 OF 23 GN-4  
 PLAN NO. **AP-177A**

10/25/00 08:57 P:\PROJECTS\Torrance\_Municipal\_Airport\_LSP\_Design\1.7\_Design\Drawings\GN-4.dwg